


KETERANGAN :

- = PHOTOVOLTAIC BATTERY DETECTOR
- = PAIR OF BIRD NEST DETECTOR
- = GAS DETECTOR
- = GAS DETECTOR
- = ALARUM BOM FIRE ALARM

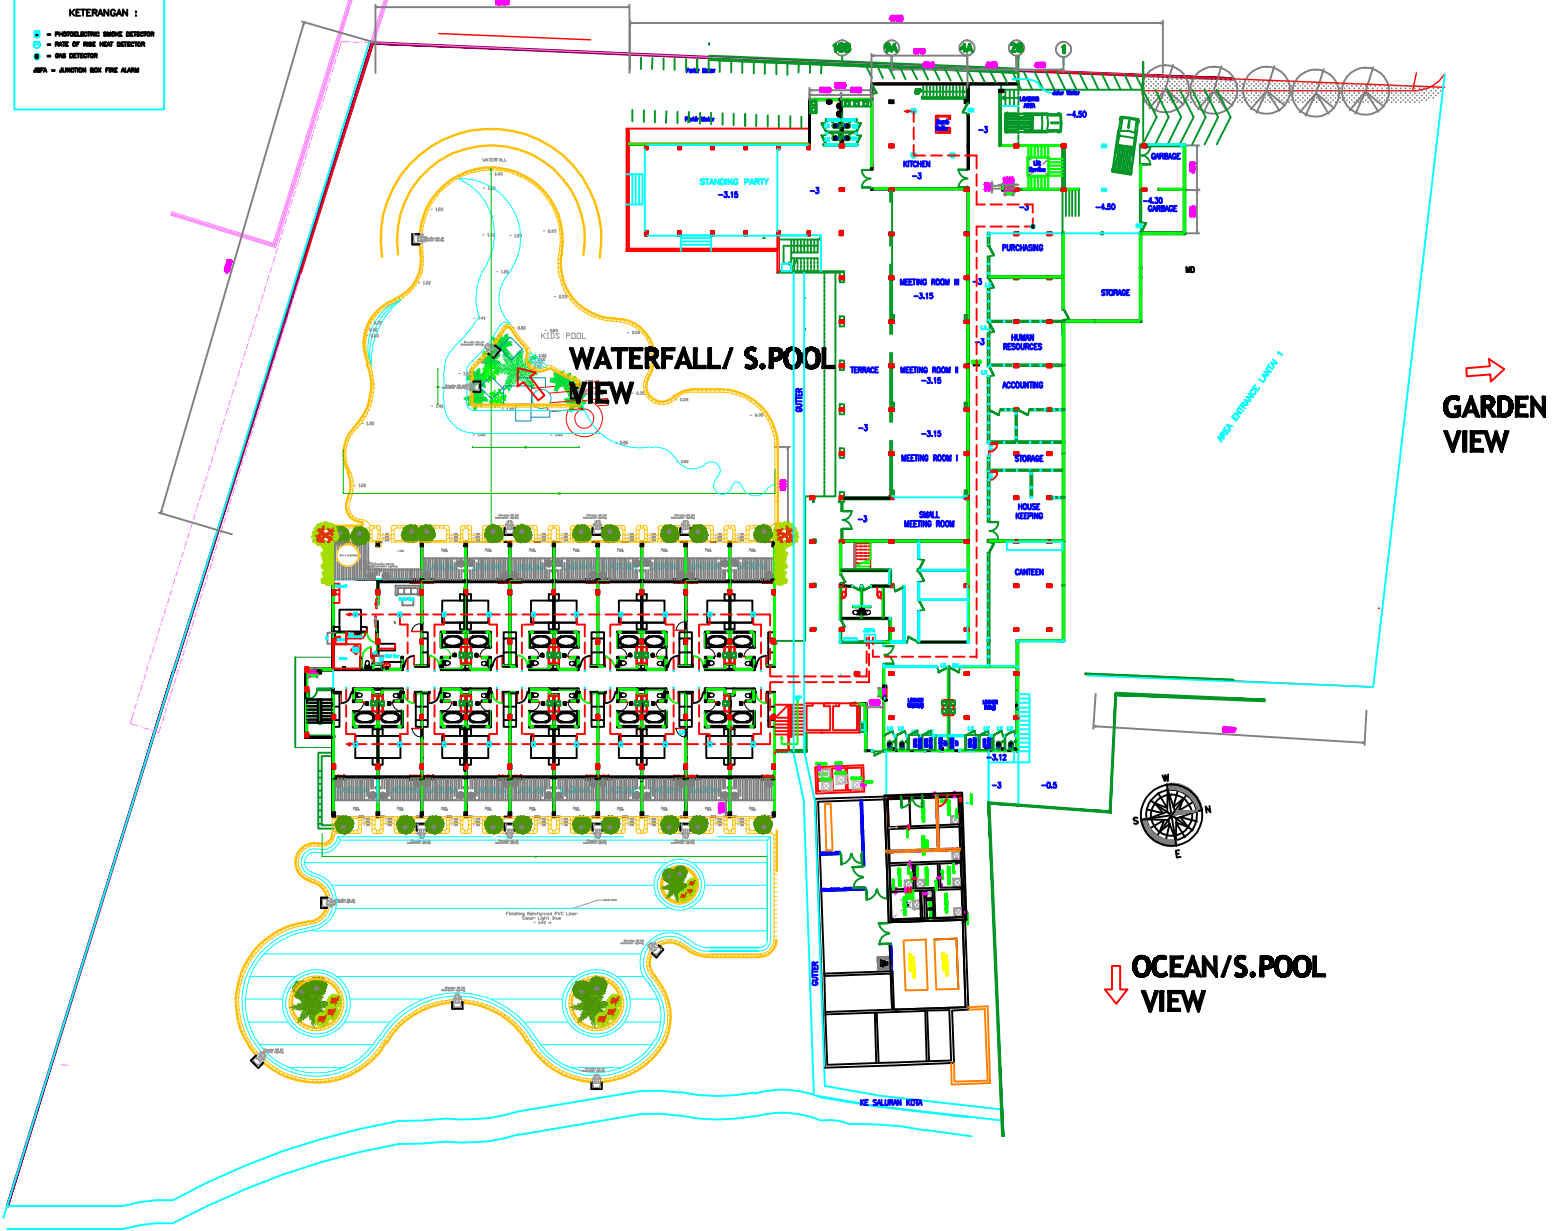

Note

Architect
 Salim Abdullah architect
 Indra Central Building
 Jl. Laksda, Komplek Ruko Cempaka Putih, Jakarta 10000
 Phone : (021) 4507240, 4507340 Fax : (021) 4507350
 E-mail : Salim@indohome.com

Project

 swiss-baldental sekara
 RUSA DUA - BALI

Owner

 Asiapac Pancamasikmur Abadi

Owner Approved

Drawing Issuance

No Issue	Date
1	
2	
3	

Structure

Copyright

Consultant ME

 PT. MALINDA MITRA TEKNIK
 ENGINEERING CONSULTANT & SERVICES
 Gedung M. Hidayat, Jl. Hidayat, No. 1, Jakarta Pusat
 Telp : (021) 4507240, 4507340 Fax : (021) 4507350
 E-mail : malinda@mitrateknik.com

Consultant Landscape

 PT. SEKAR WATU DAMAR
 LANDSCAPE ARCHITECTURE & SERVICES
 Gedung M. Hidayat, Jl. Hidayat, No. 1, Jakarta Pusat
 Telp : (021) 4507240, 4507340 Fax : (021) 4507350
 E-mail : sekar@sekarwatumdamar.com

Drawing Title

**INSTALLASI FIRE ALARM
 18T FLOOR
 GARDENIA**

Scale : 1 : 400
 Drawing By : Agus Subriano.ST
 Check By : Edy Wihardy

AS-BUILT DRAWING

Date	Drawing code
5 Agustus 2011	M-FA-201